



your artists and craftsmen of outdoor spaces
designing, crafting and managing
quality landscape spaces

AS BUILT

1069 S. Duncan Rd.
Champaign, Illinois 61822-9656

217.355.9422
fax: 217.378.8410

prairieviewlandscaping.com

DRAKE HOMES

scale: 1/8" = 1'-0"

drafted by: JASON RHOADES

designed by: ERIC SEBENS

date: 3-20-09

revisions:

by: date:

by: date:

by: date:

NOTICE: This design and all items, concepts and layouts contained herein are property of Prairieview Landscaping Company. Reproduction, publication or re-use of this design by any method in whole or part is prohibited. Visual contact with this design shall constitute prima facie evidence of these restrictions. Any violations of this warning may result in legal action.

This design copyright© 2009 Prairieview Landscaping Company




Eric Sebens
REGISTERED IRRIGATOR
CERTIFIED IRRIGATION CONTRACTOR



Page No. 1 of 1

DRAKE HOMES

↑
LAKE

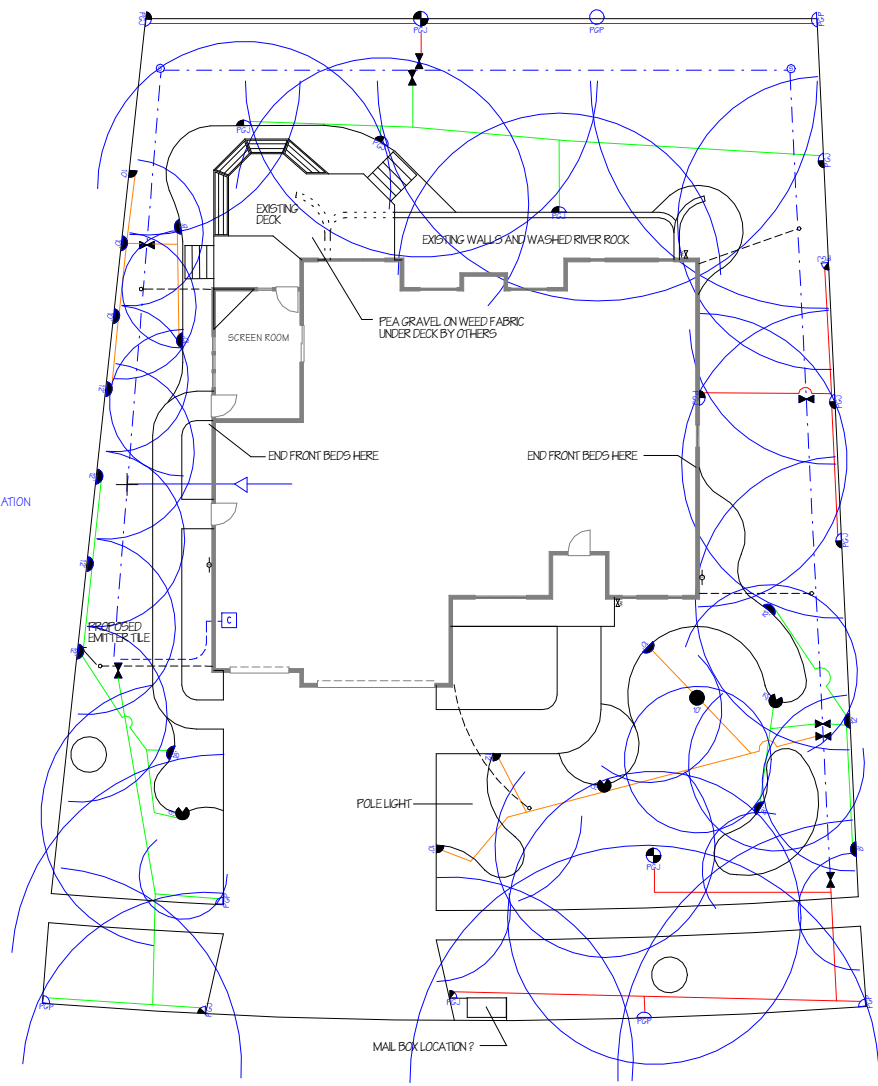

IRRIGATION SYSTEM COMPONENTS

- HUNTER PRO-C - IRRIGATION CONTROLLER
- ▽ POINT OF CONNECTION
- ⊗ FEBCO 825Y BACKFLOW PREVENTION DEVICE
- ⊗ HUNTER PGV 1" 24 VOLT IRRIGATION CONTROL VALVE
- ▲ HUNTER PRO-SPRAY IRRIGATION HEAD
- ▲ HUNTER PGJ IRRIGATION HEAD
- ▲ HUNTER PGP IRRIGATION HEAD
- NELSON 1" QUICK COUPLER VALVE
- 1" PVC SDR 21 PIPE (ZONE LINE)
- - - 1" PVC SDR 21 PIPE (MAN LINE)
- ⊙ HP, IRRIGATION PRESSURE BOOSTER PUMP
- ⊙ METER PIT
- ⊙ WIRE SPLICE
- ~ DRIP IRRIGATION
- SPECIALTY DOUBLE WIDE IRRIGATION HEAD
- SPECIALTY SINGLE WIDE IRRIGATION HEAD
- ▲ RAIN SENSOR



QUALITY ASSURANCE CHECKLIST

- ALL TRENCHES/SEAMS LEVELED (RUN OVER) WITH THE PULLER
- "AS BUILT" COMPLETED
- ALL CLEAN-UP DONE "AS IF WE WERE NEVER THERE"
- ALL HEADS PROPERLY ADJUSTED
- SYSTEM RUN THROUGH COMPLETELY WITH CONTROLLER TO INSURE FULL OPERATION
- CONTROLLER PROGRAMMED, LABELED & SET TO OPERATE
- REVIEW CONTROLLER OPERATION WITH CUSTOMER
- MAN HOURS PROPERLY TRACKED AND SUBMITTED TO P/O MANAGER